


SITE PLAN


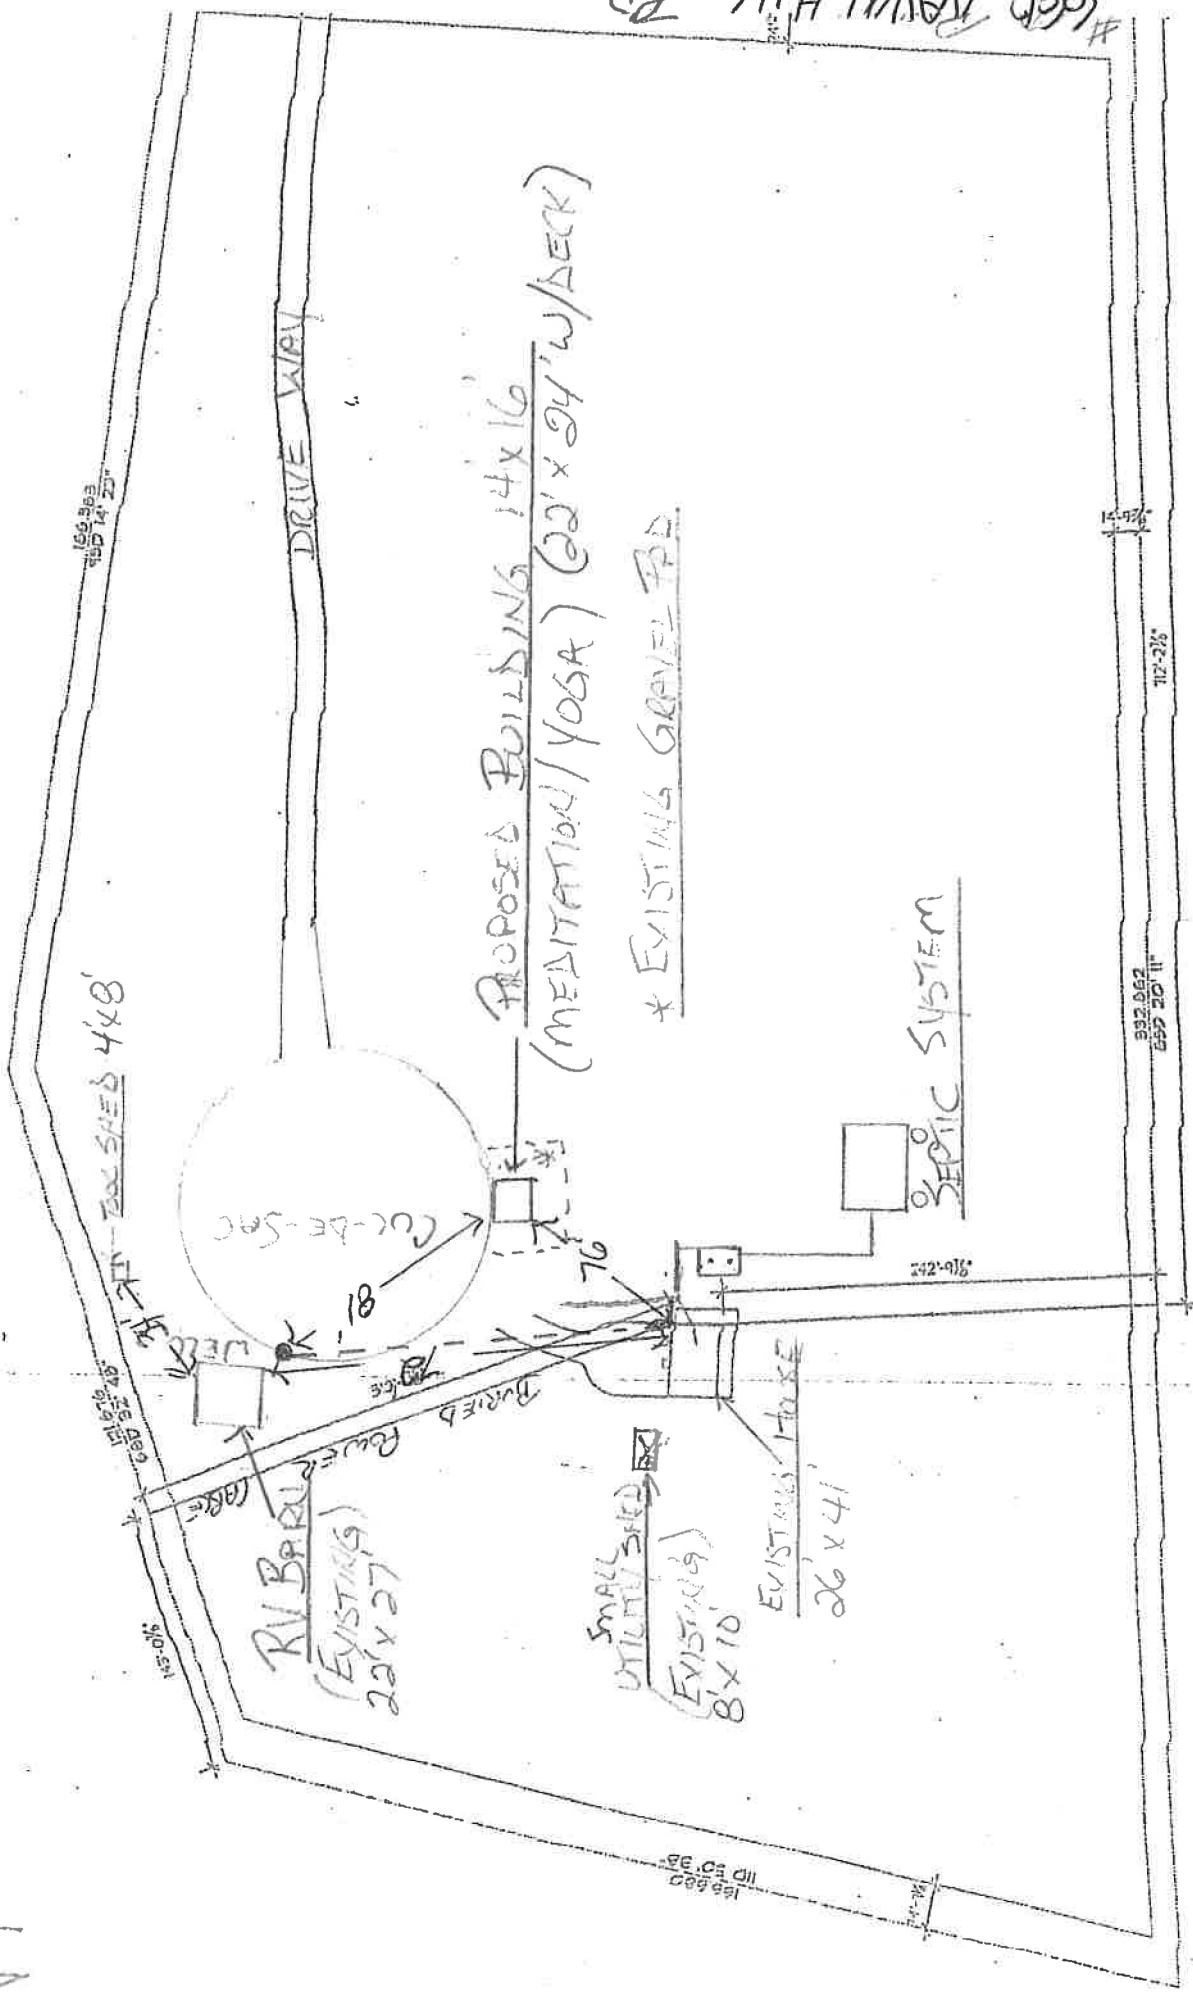


#666 KAWAHI HILL RD.


LEGAL DESCRIPTION
LOT 1, PLAN KAP1565


LANDING FEES

As Built Drawing

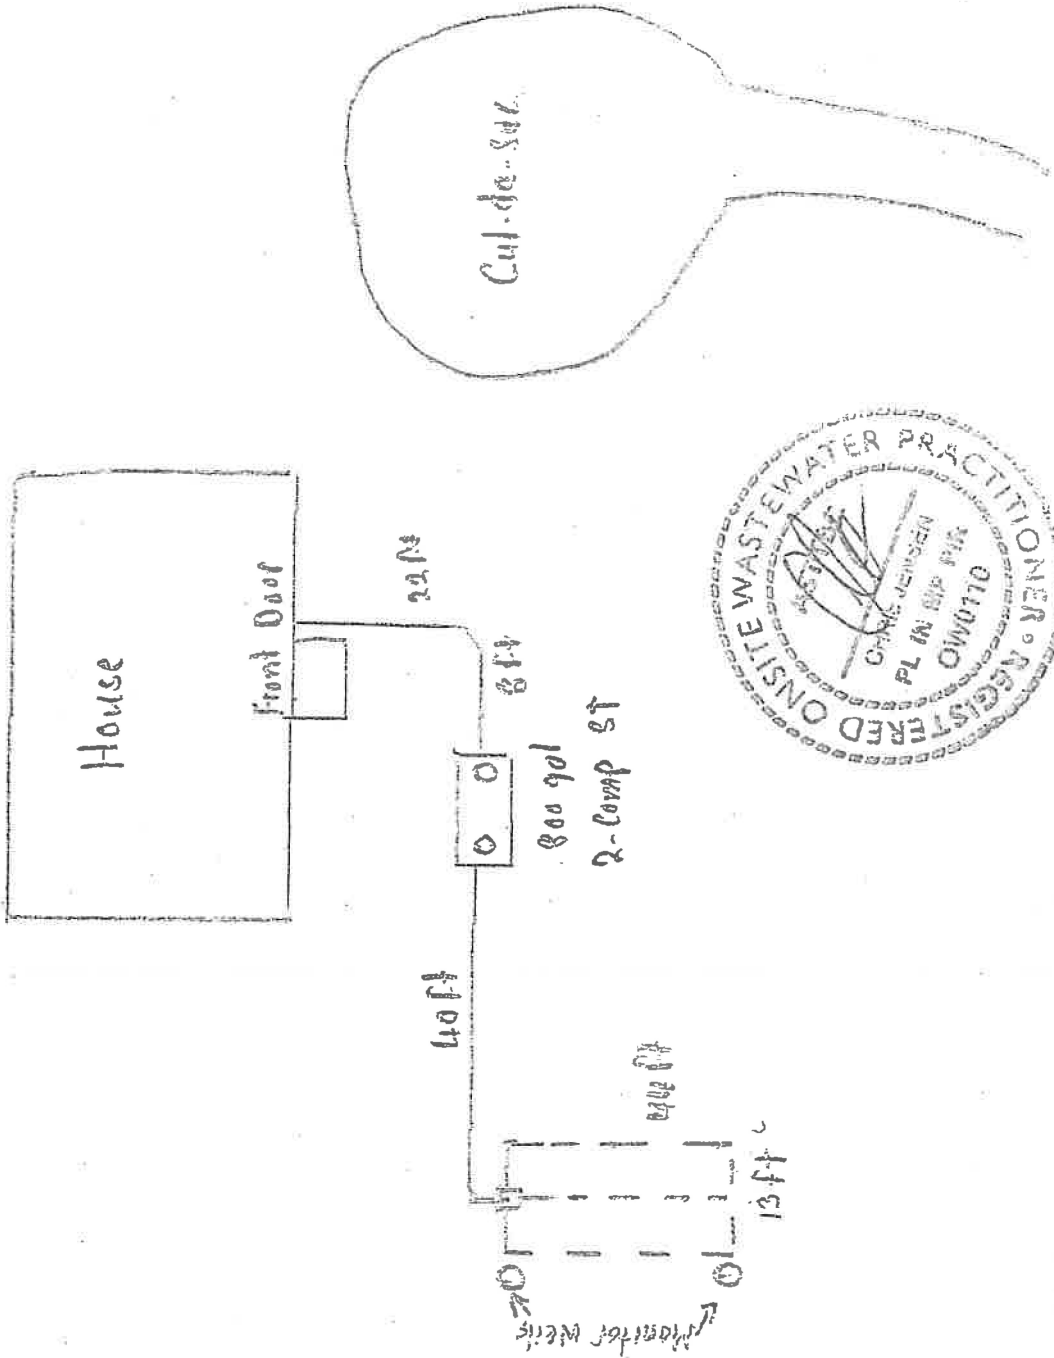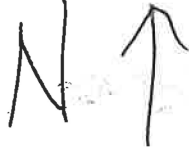

12-01-07

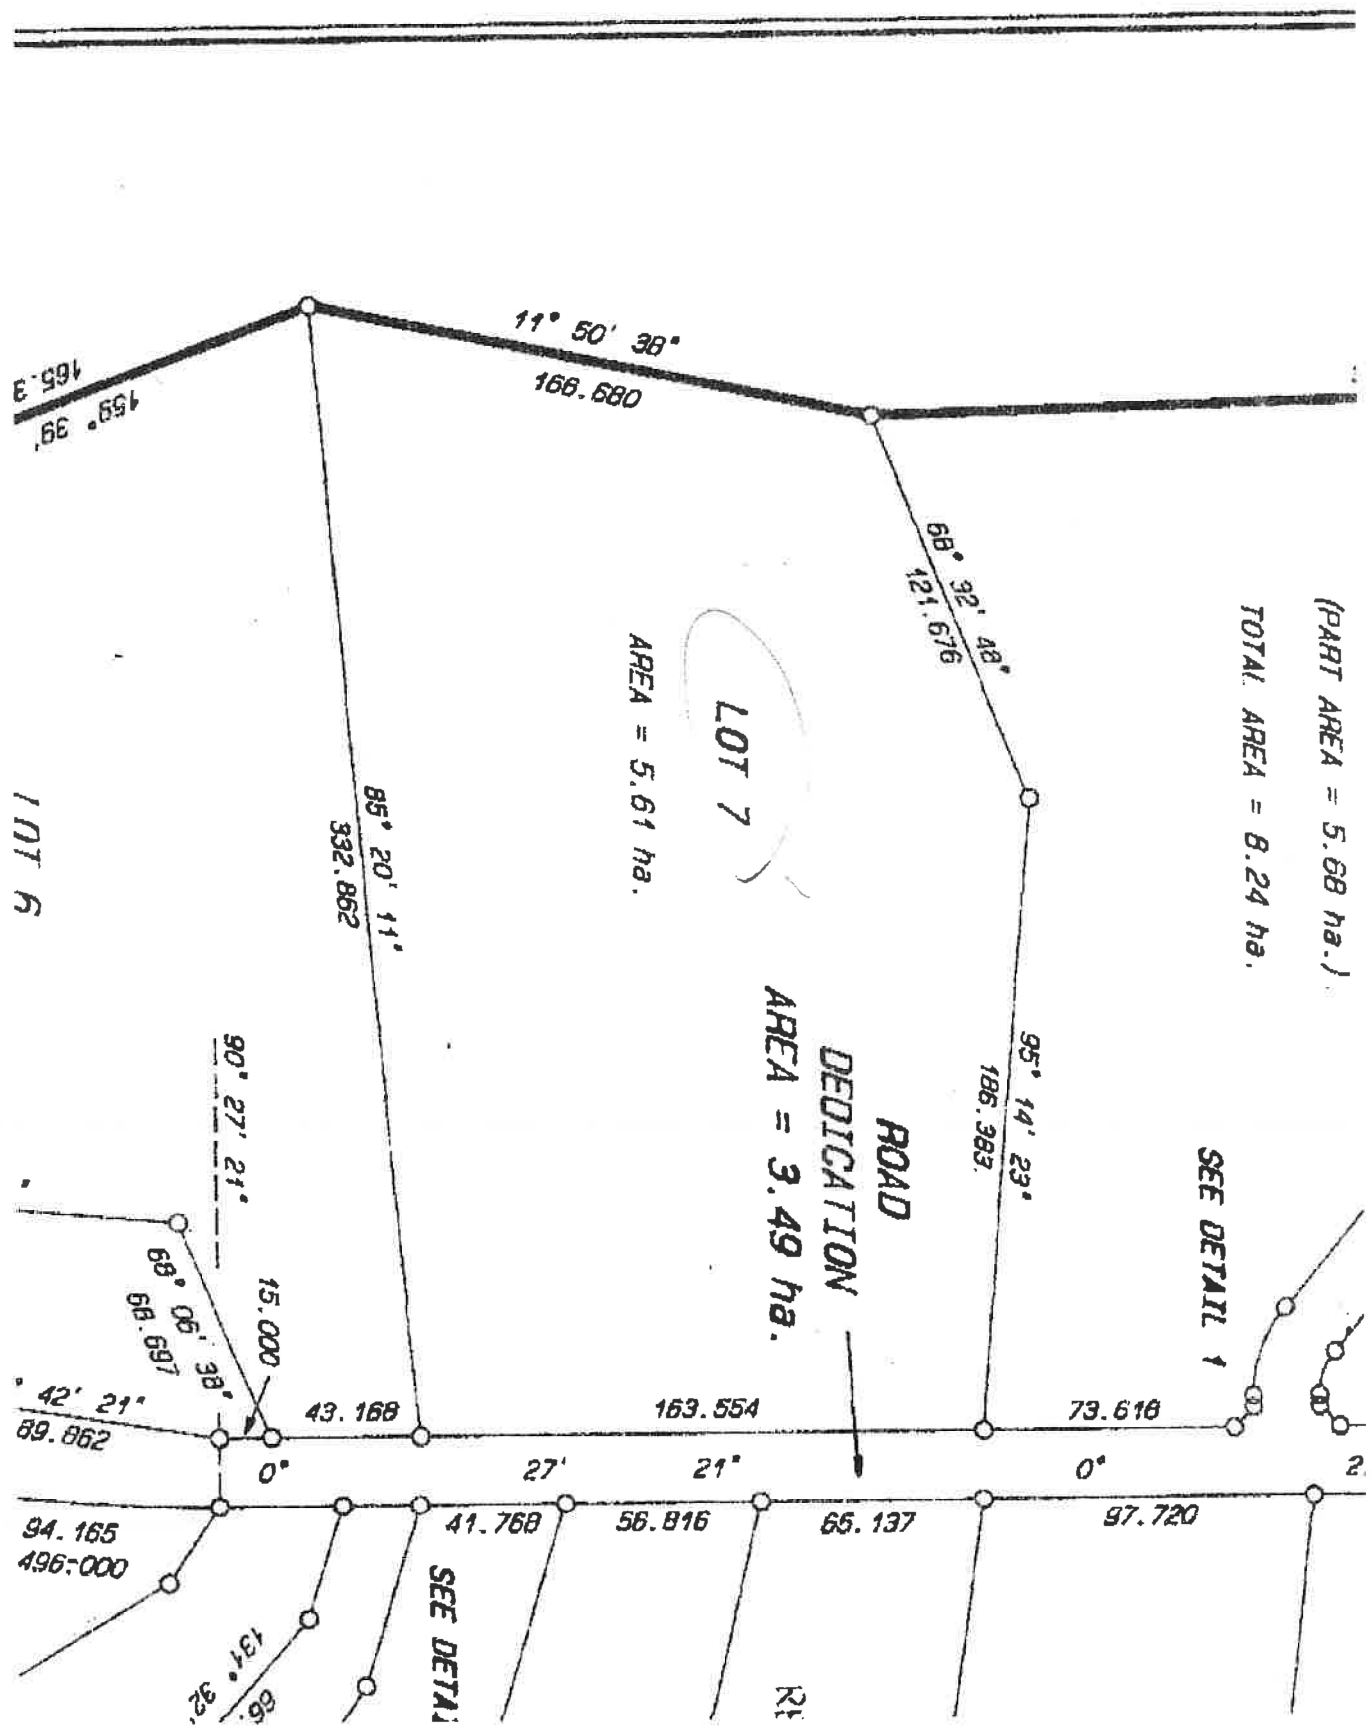

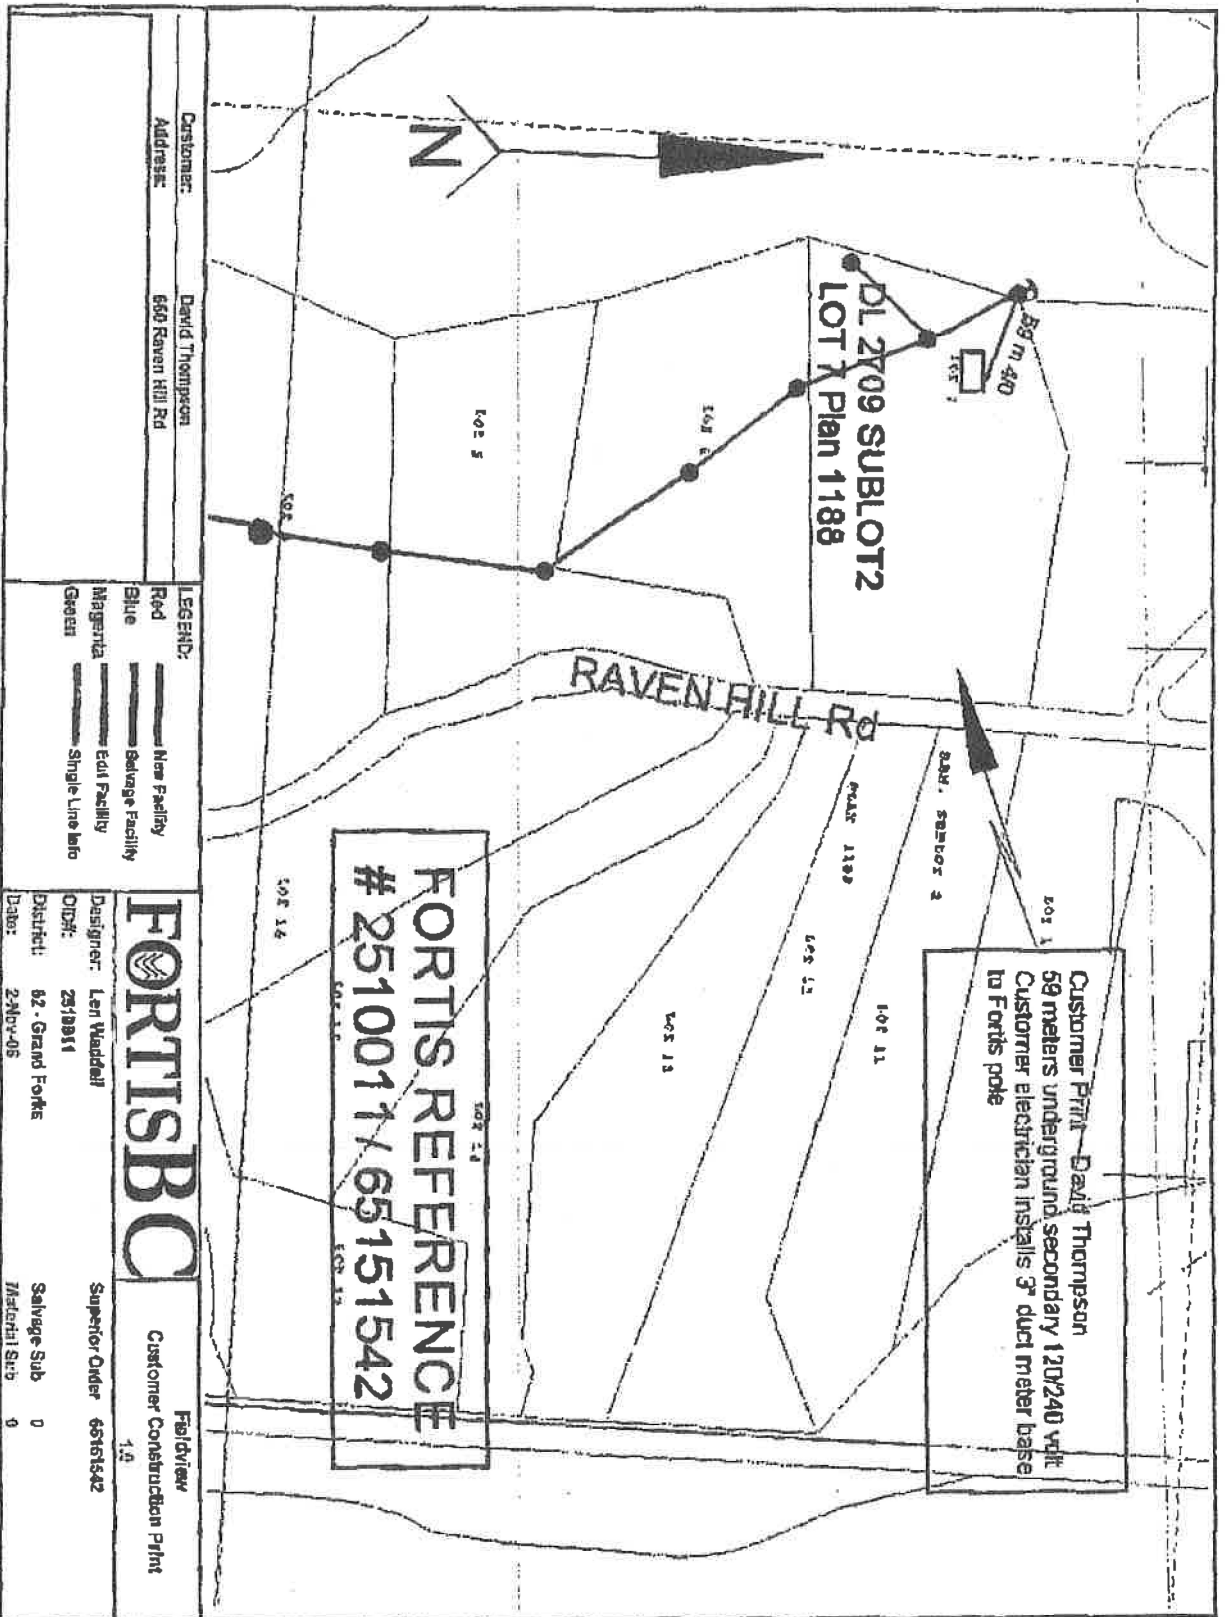

Customer Print: David Thompson
 59 meters underground secondary 120/240 volt
 Customer electrician installs 3" duct meter base
 to Fortis pole

FORTIS REFERENCE
2510011765151542

| | |
|----------------------------|---------------------------------|
| Customer: David Thompson | |
| Address: 660 Raven Hill Rd | |
| LEGEND: | |
| Road | New Facility |
| Blue | Salvage Facility |
| Magenta | Edt Facility |
| Green | Single Line into |
| FORTISBC | |
| Designer: Len Waddell | Superior Order 66161642 |
| OID#: 2510011 | Customer Construction Print 1.0 |
| District: 62 - Grand Forks | Salvage Sub 0 |
| Date: 2-Nov-05 | Material Sub 0 |



PROPOSED YOGA MEDITATION BUILDING.